

SEC. 11, TWP. 24, N RNG. 1 E, W.M. KITSAP COUNTY, WASHINGTON

FROM THE LEASE JACKETS OF:

AQUATIC RESOURCES-DNR

POSSIBLE UNOFFICIAL MODIFICATIONS
MAY EXIST. CHECK ORIGINAL MAP FOR
VERIFICATION.

Description of Easement for Right of Way for Utility Line Across
Aquatic State Owned Lands

Part A

A strip of land 15 feet in width, 7.5 feet left and right of
the following described centerline, situated in Section 11,
Township 24 North, Range 1 East, Willamette Meridian, Kitsap
County, Washington.


Commencing at the Southwest corner of said Section 11; thence
North 84° 51' 22" East 1056.86 feet to a point on the State Inner
Harbor Line per State of Washington Board of State Land Commissioners,
Maps of Bremerton Tide Lands 28 February 1913 (Page 5); said point
being the True Point of Beginning; thence North 46° 42' 46" East
29.25 feet; thence North 54° 38' 02" East 210.16 feet; thence North
65° 53' 02" East 114.00 feet, thence South 69° 06' 58" East 238.32
feet to a point on the State Inner Harbor Line and the Terminus
Point of said easement.

Part B


A strip of land 15 feet in width, 7.5 feet left and right of the
following described centerline, situated in Section 11, Township 24
North, Range 1 East, Willamette Meridian, Kitsap County, Washington.

Commencing at the Southwest corner of said Section 11; thence North
84° 53' 22" East 1700.97 feet to a point on the State Inner Harbor
Line per State of Washington Board of State Land Commissioners, Maps
of Bremerton Tide Lands, 28 February 1913 (Page 5); said point being
the True Point of Beginning; thence South 69° 06' 58" East 99.85
feet, thence South 73° 25' 53" East 237.73 feet; thence North 83°
51' 01" East 145.44 feet; thence South 73° 38' 59" East 101.00 feet;
thence South 29° 00' 43" East 36.05 feet; thence South 6° 30' 44"
East 39.77 feet to a point on the State Inner Harbor Line and the
Terminus Point of said easement.

Except that portion not lying within aquatic state owned land.

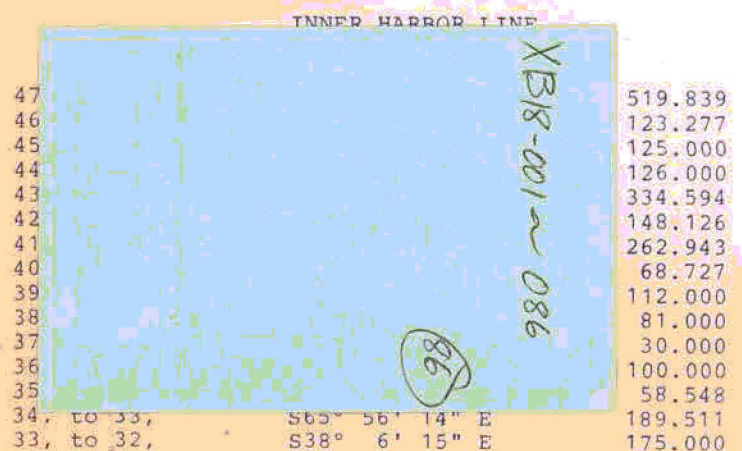

OUTER HARBOR LINE		
10, to 11,	N72° 26' 15" W	1685
11, to 12,	N22° 36' 15" W	1235

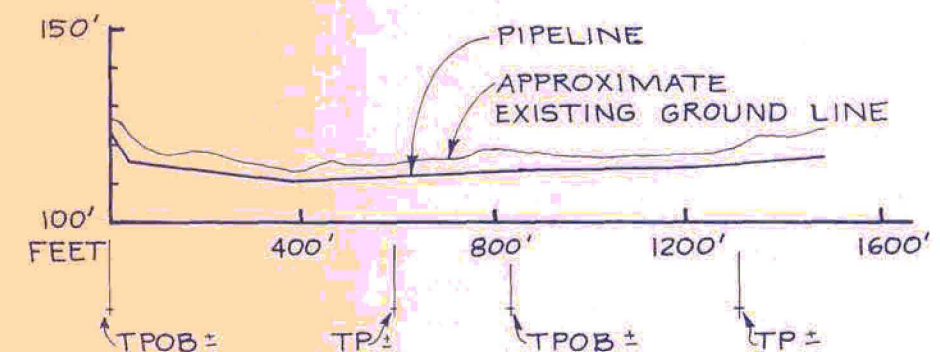

PROFILE
SCALE: 1"=400'

Description Part A
TPOB
1 North 46° 42' 46" East 29.25
2 North 54° 38' 02" East 210.16
3 North 65° 53' 02" East 114.00
TP South 69° 06' 58" East 238.32

Description Part B
TPOB
1 South 69° 06' 58" East 99.85
2 South 73° 25' 53" East 237.73
3 North 83° 51' 01" East 145.44
4 South 73° 38' 59" East 101.00
5 South 29° 00' 43" East 36.05
TP South 6° 30' 44" East 39.77

DETAIL A
SCALE: 1"=200'

LEGEND:

TPOB, True Point of Beginning
TP, Terminus Point

REFERENCED:

- State of Washington Board of State Land Commissioners, Maps of Bremerton Tide lands showing Harbor Lines and Tide Lands as Surveyed Established and Platted by order of the Board of State Land Commissioners. And filed in the Office of the Commissioner of Public Lands on the 28th day of February A.D. 1913.
- Right of Way Plat, Cascade Natural Gas Co. Section 11 and 14, TWP. 24N., RGE. 1E., W.M. Kitsap County, Washington. This Plat was done by Jones and Associates on the 6th day of November 1974.


VERTICAL DATUM: City of Bremerton (the relationships between the City of Bremerton Datum, and the Puget Sound Naval Shipyard Datum are shown below.)

BASIS OF BEARING: Washington State Plane Coordinate System, North Zone

CONVERSION TABLE	CITY	P.S.N.S.
Extreme High Water (EHW)	125.15	124.8
Mean Higher High Water (MHHW)	121.45	121.1
Mean High Water (MHW)	120.55	120.2
Mean Tide Level (MTL)	116.55	116.2
Mean Lower Low Water (MLLW)	109.75	109.4
Extreme Low Water (ELW)	105.35	105.0

SCALE: 1" = 400'

51-045730

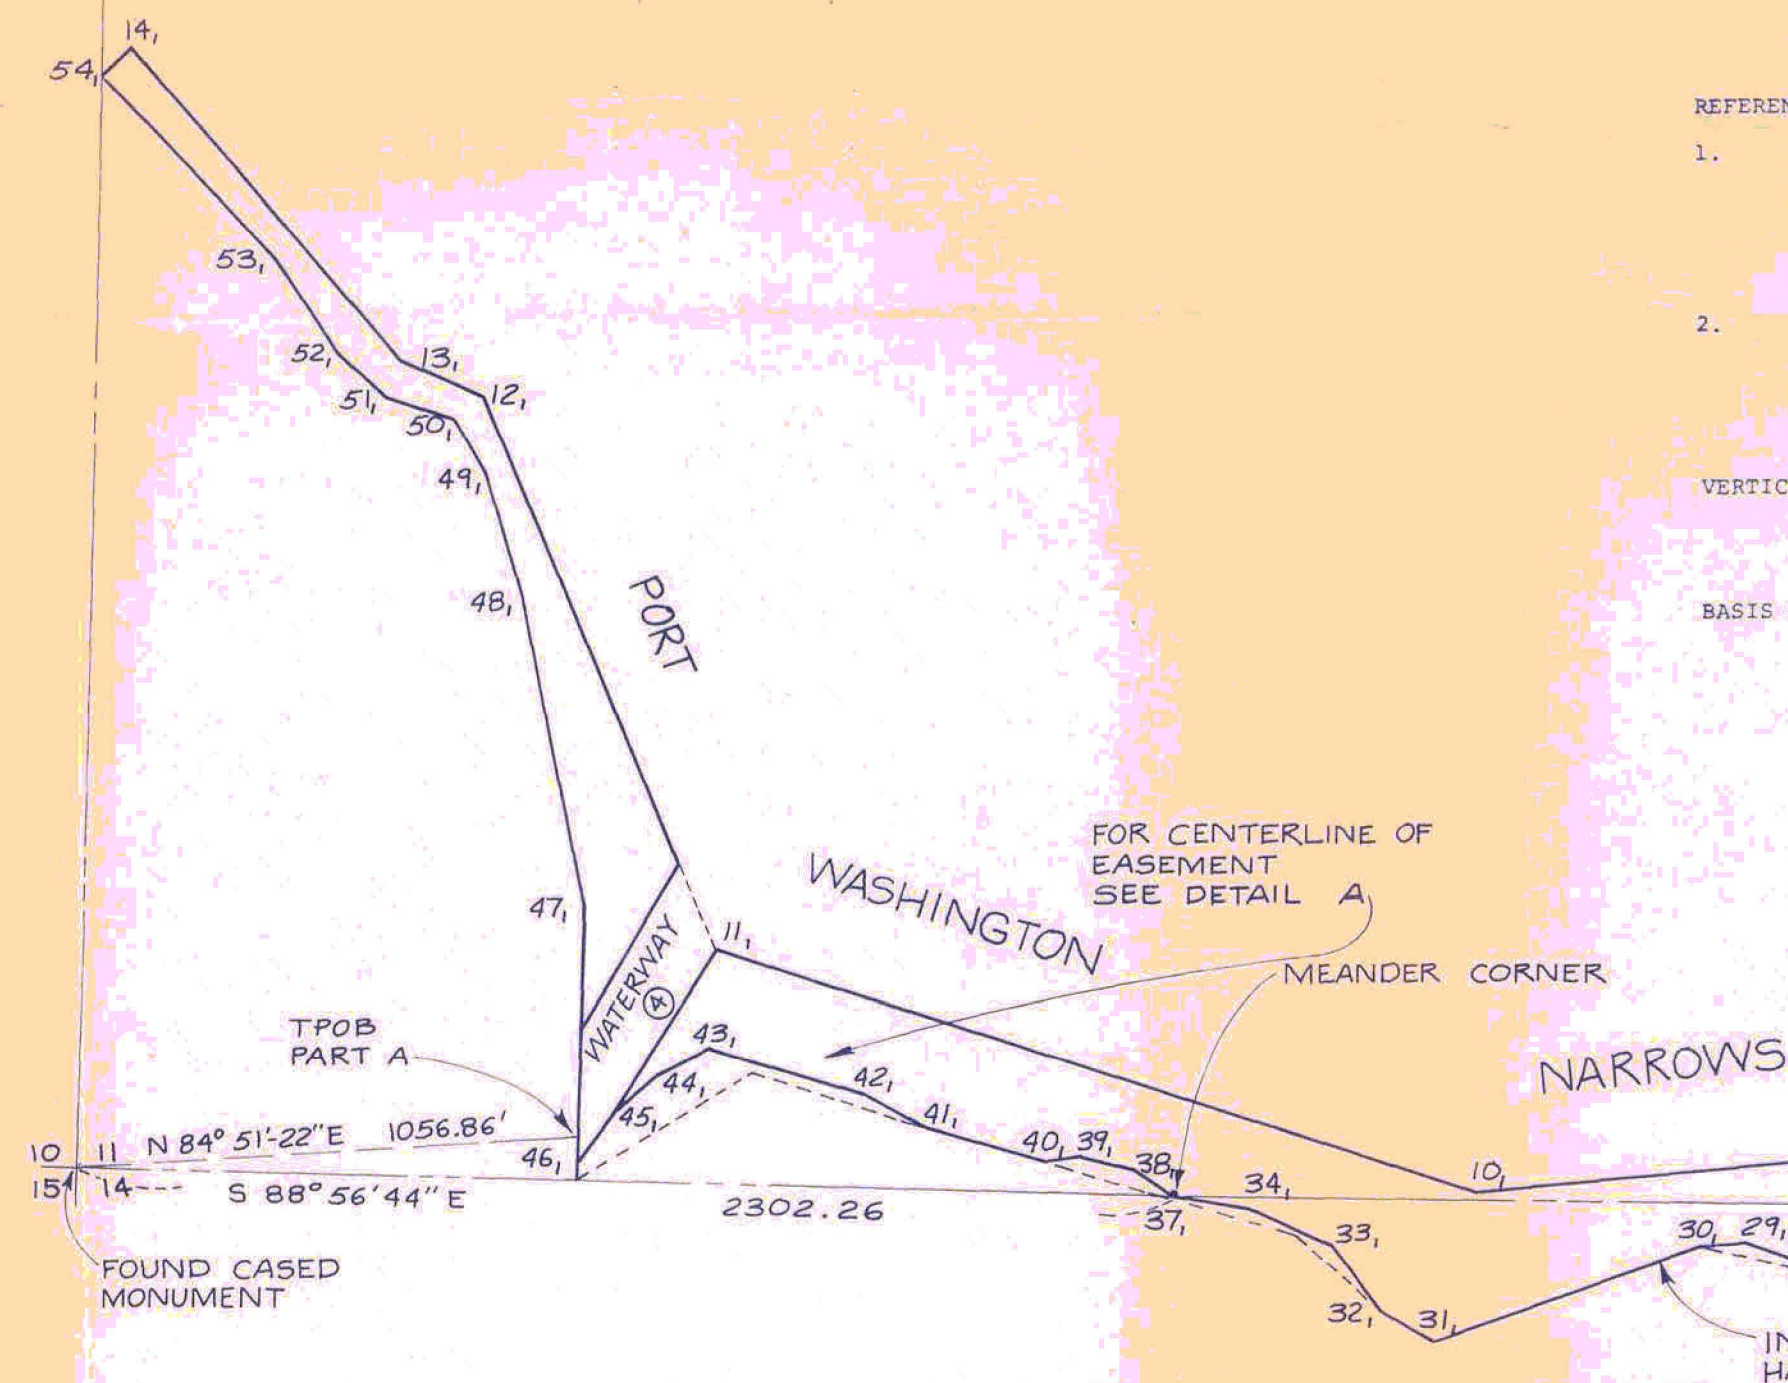


CH2M HILL

RECORDER'S CERTIFICATE

Filed for record this ____ day of _____, 19__ at
____ M. in Book ____ of Surveys at page ____
at the request of _____
Manager _____ Superintendent of Records _____

SURVEYOR'S CERTIFICATE

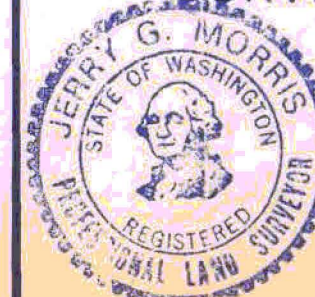

This map correctly represents a survey made by me
or under my direction in conformance with the
requirements of the Survey Recording Act at the
request of CITY OF BREMERTON
in AUGUST, 1983.

Certificate No. 17673

RECORD SURVEY
for
CITY OF BREMERTON
DNR EASEMENT
PORT WASHINGTON
NARROWS TIDELANDS